



B1

攝影機 25

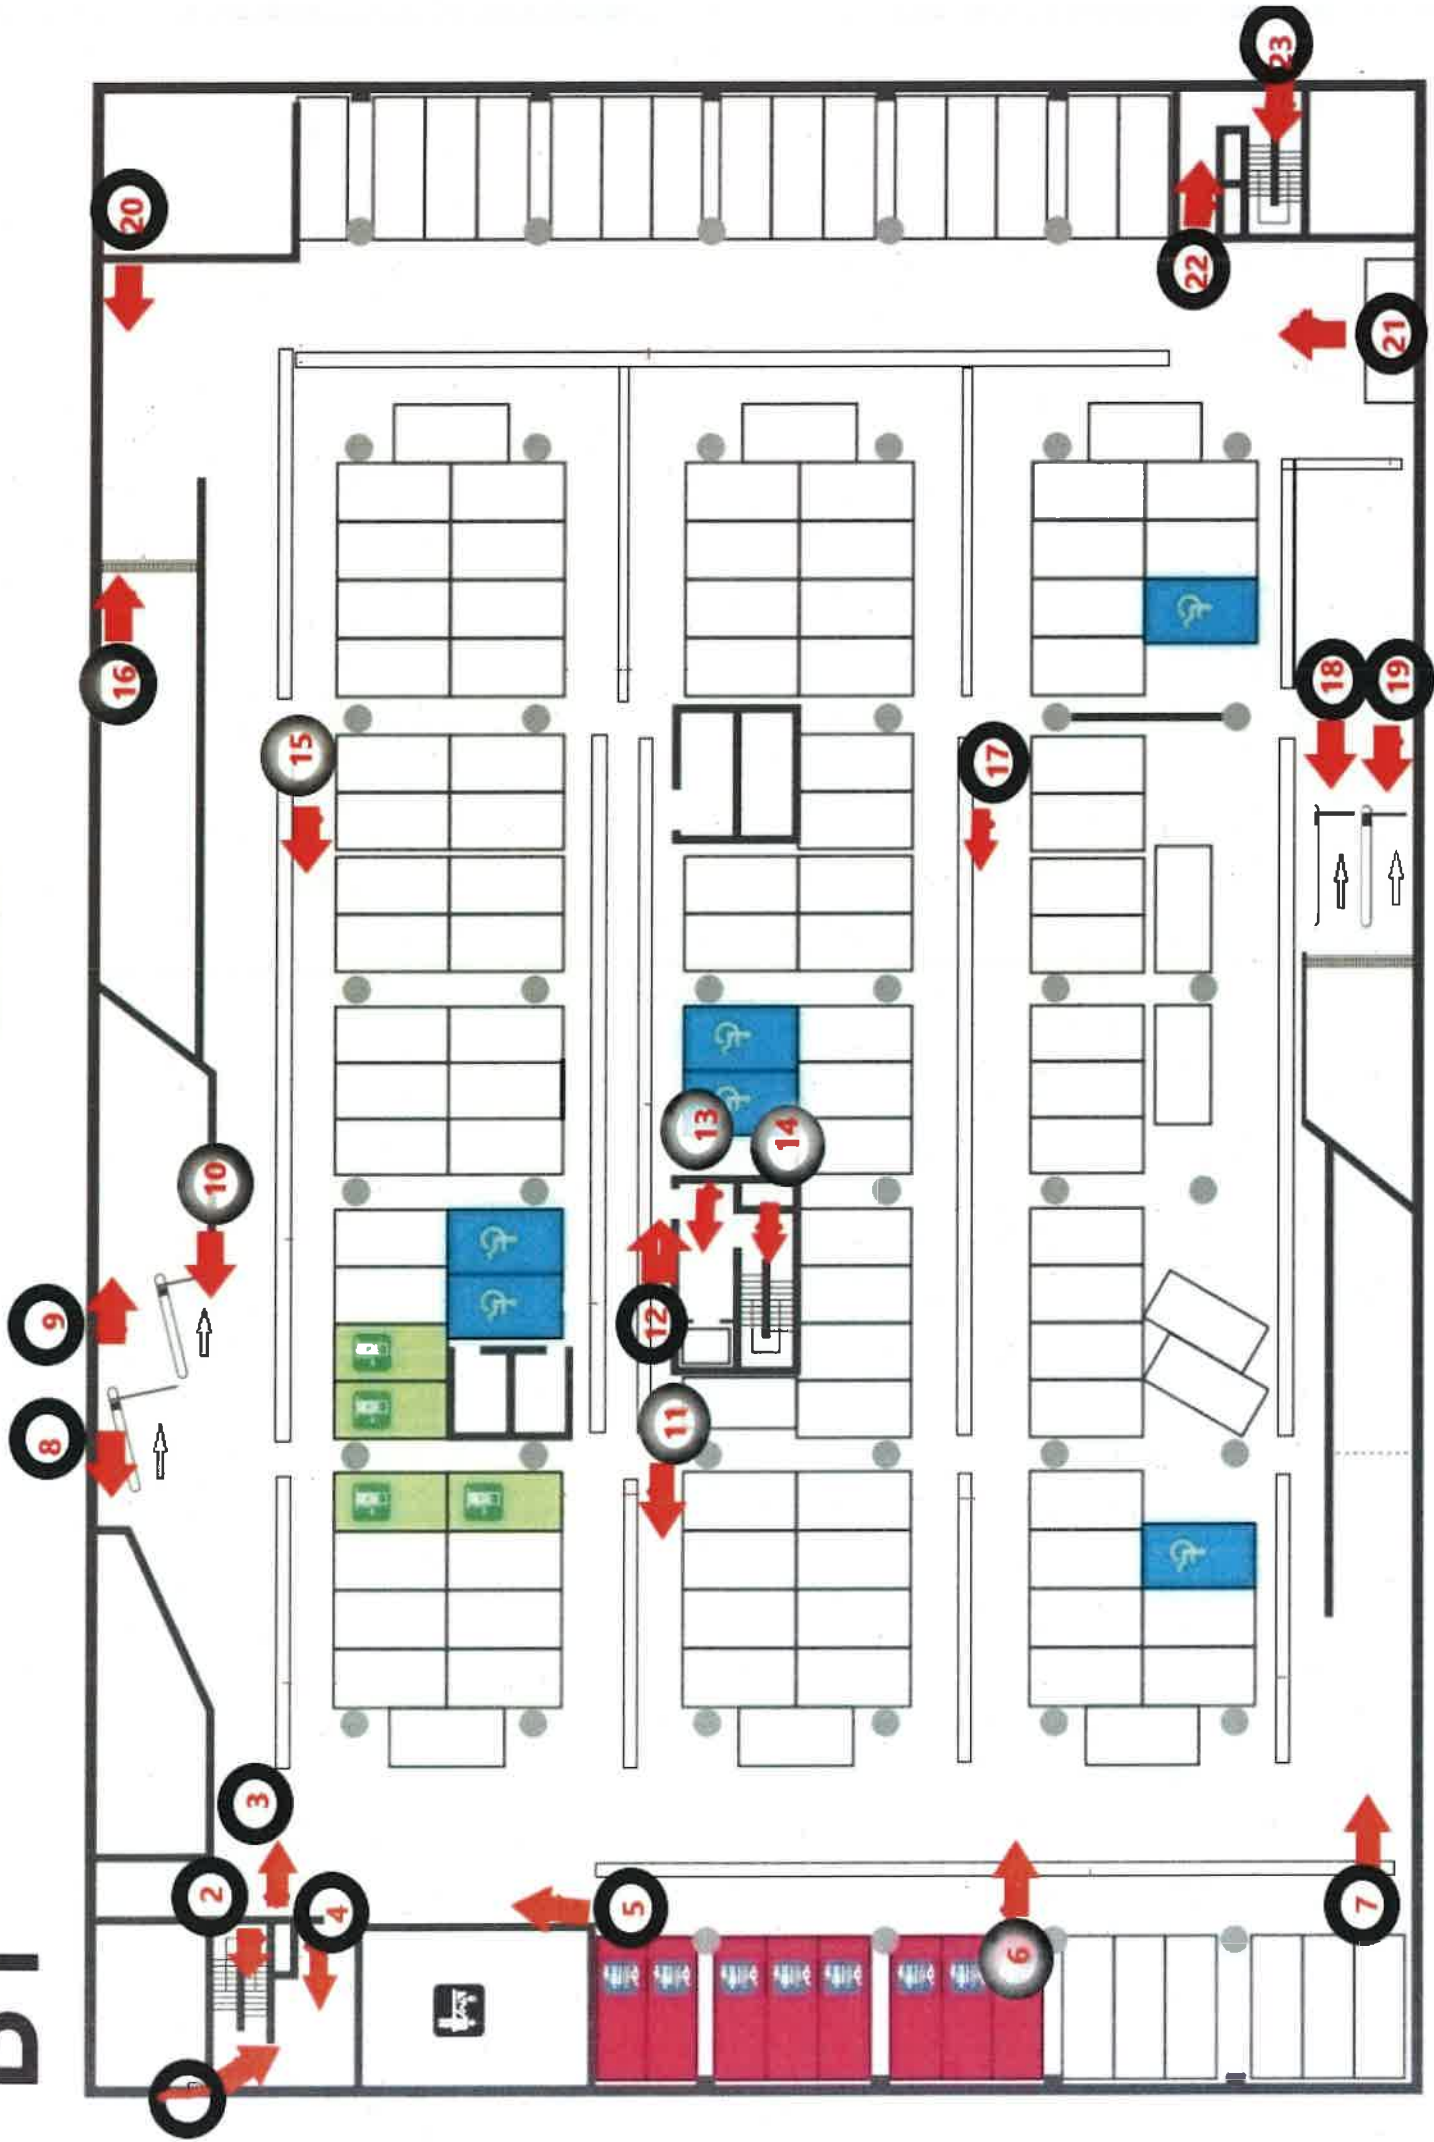

B2

攝影機 12

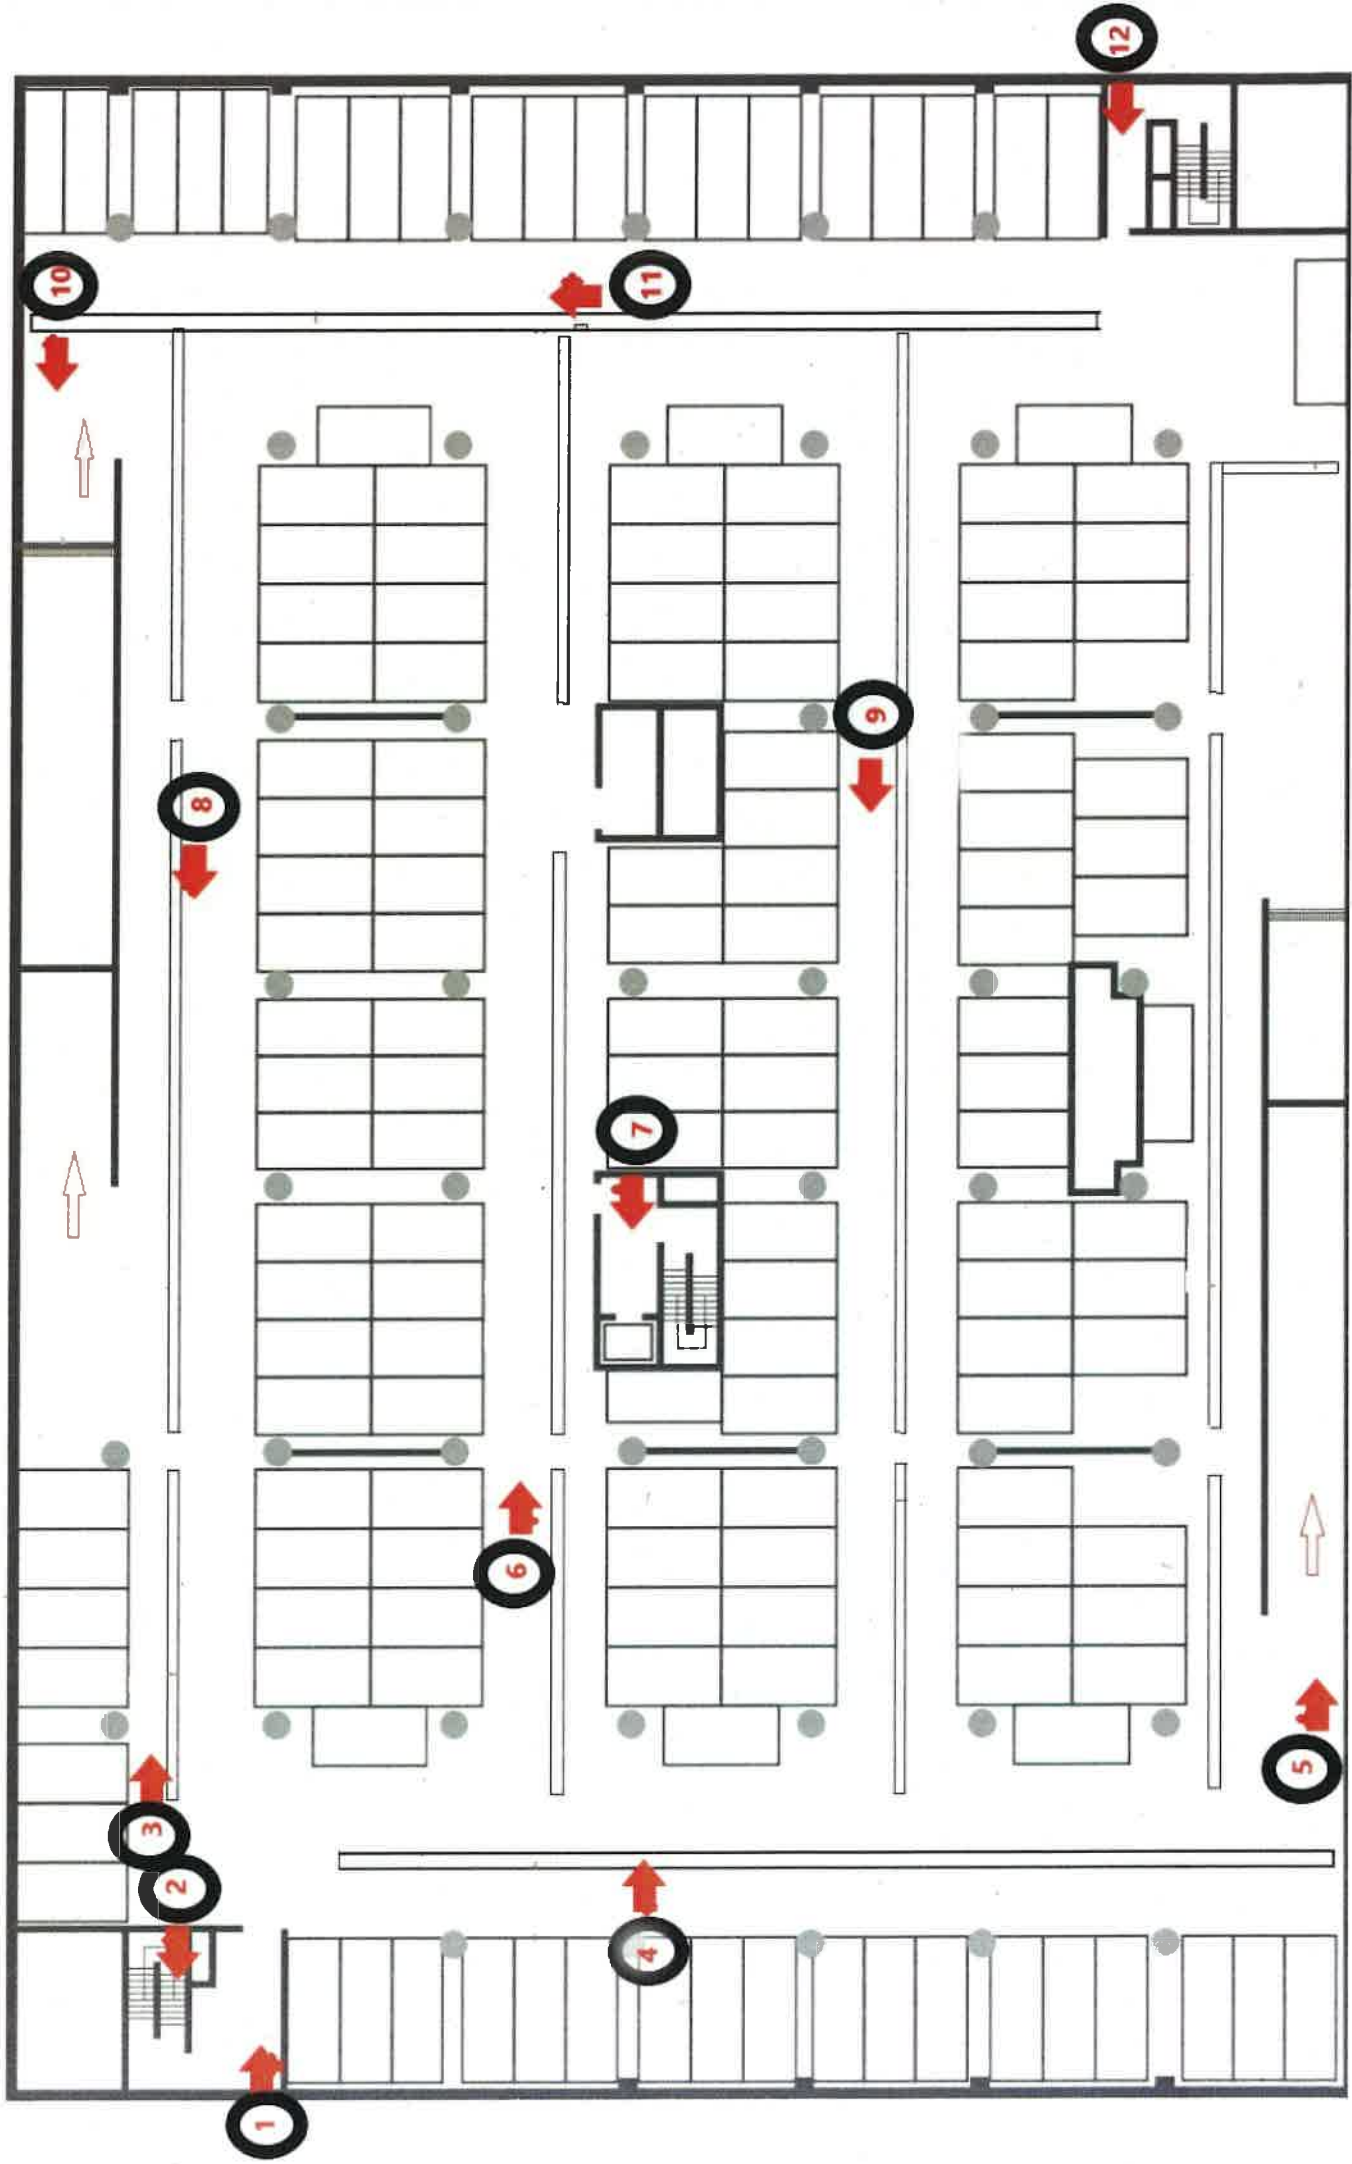

B3

- 1 一對一攝影機
- 2 一對三攝影機
- 3 一對六攝影機

